
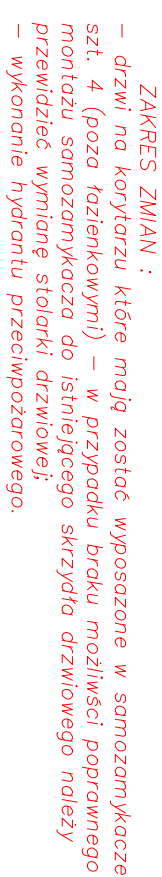
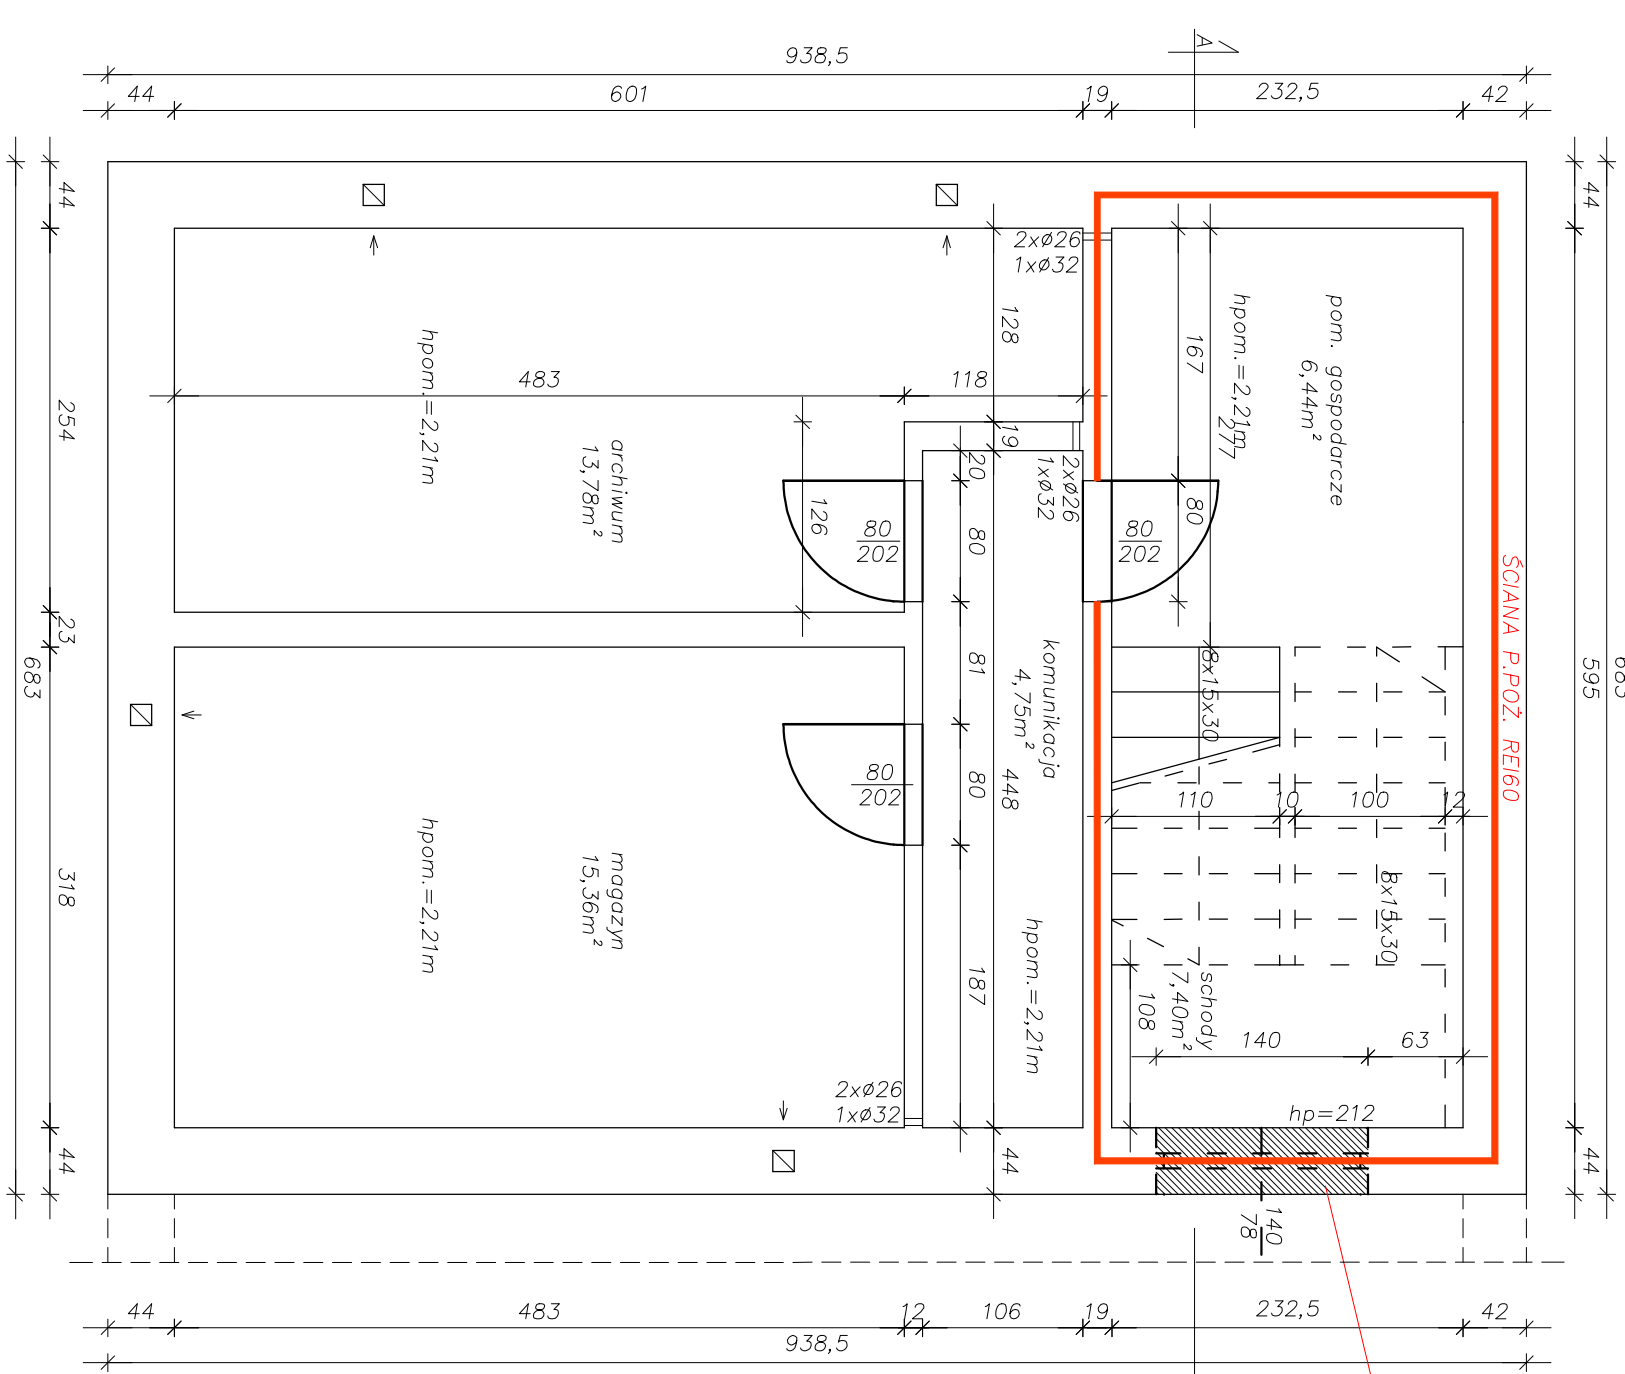


Architectural floor plan of a bathroom. The plan shows a rectangular room with a door labeled "drzwi otw. 180°" and a red exclamation mark. Dimensions include 189, 211, 220, 200, 280, 314, 307, 42, 4.2, 4.53, 4.09, 3.3, 4.00, 4.85, 3.47, and 3.3. Annotations include "drzwi otw. 180°", "!", "4.85", "4.09", "4.00", "3.47", and "3.3". A red line indicates a wall or partition. The plan is oriented with a north arrow pointing towards the top right.

[illegible]

PRZEDSZKOLE NR 3
Rzut piwnic z klatką schodową "K1"
skala 1:50

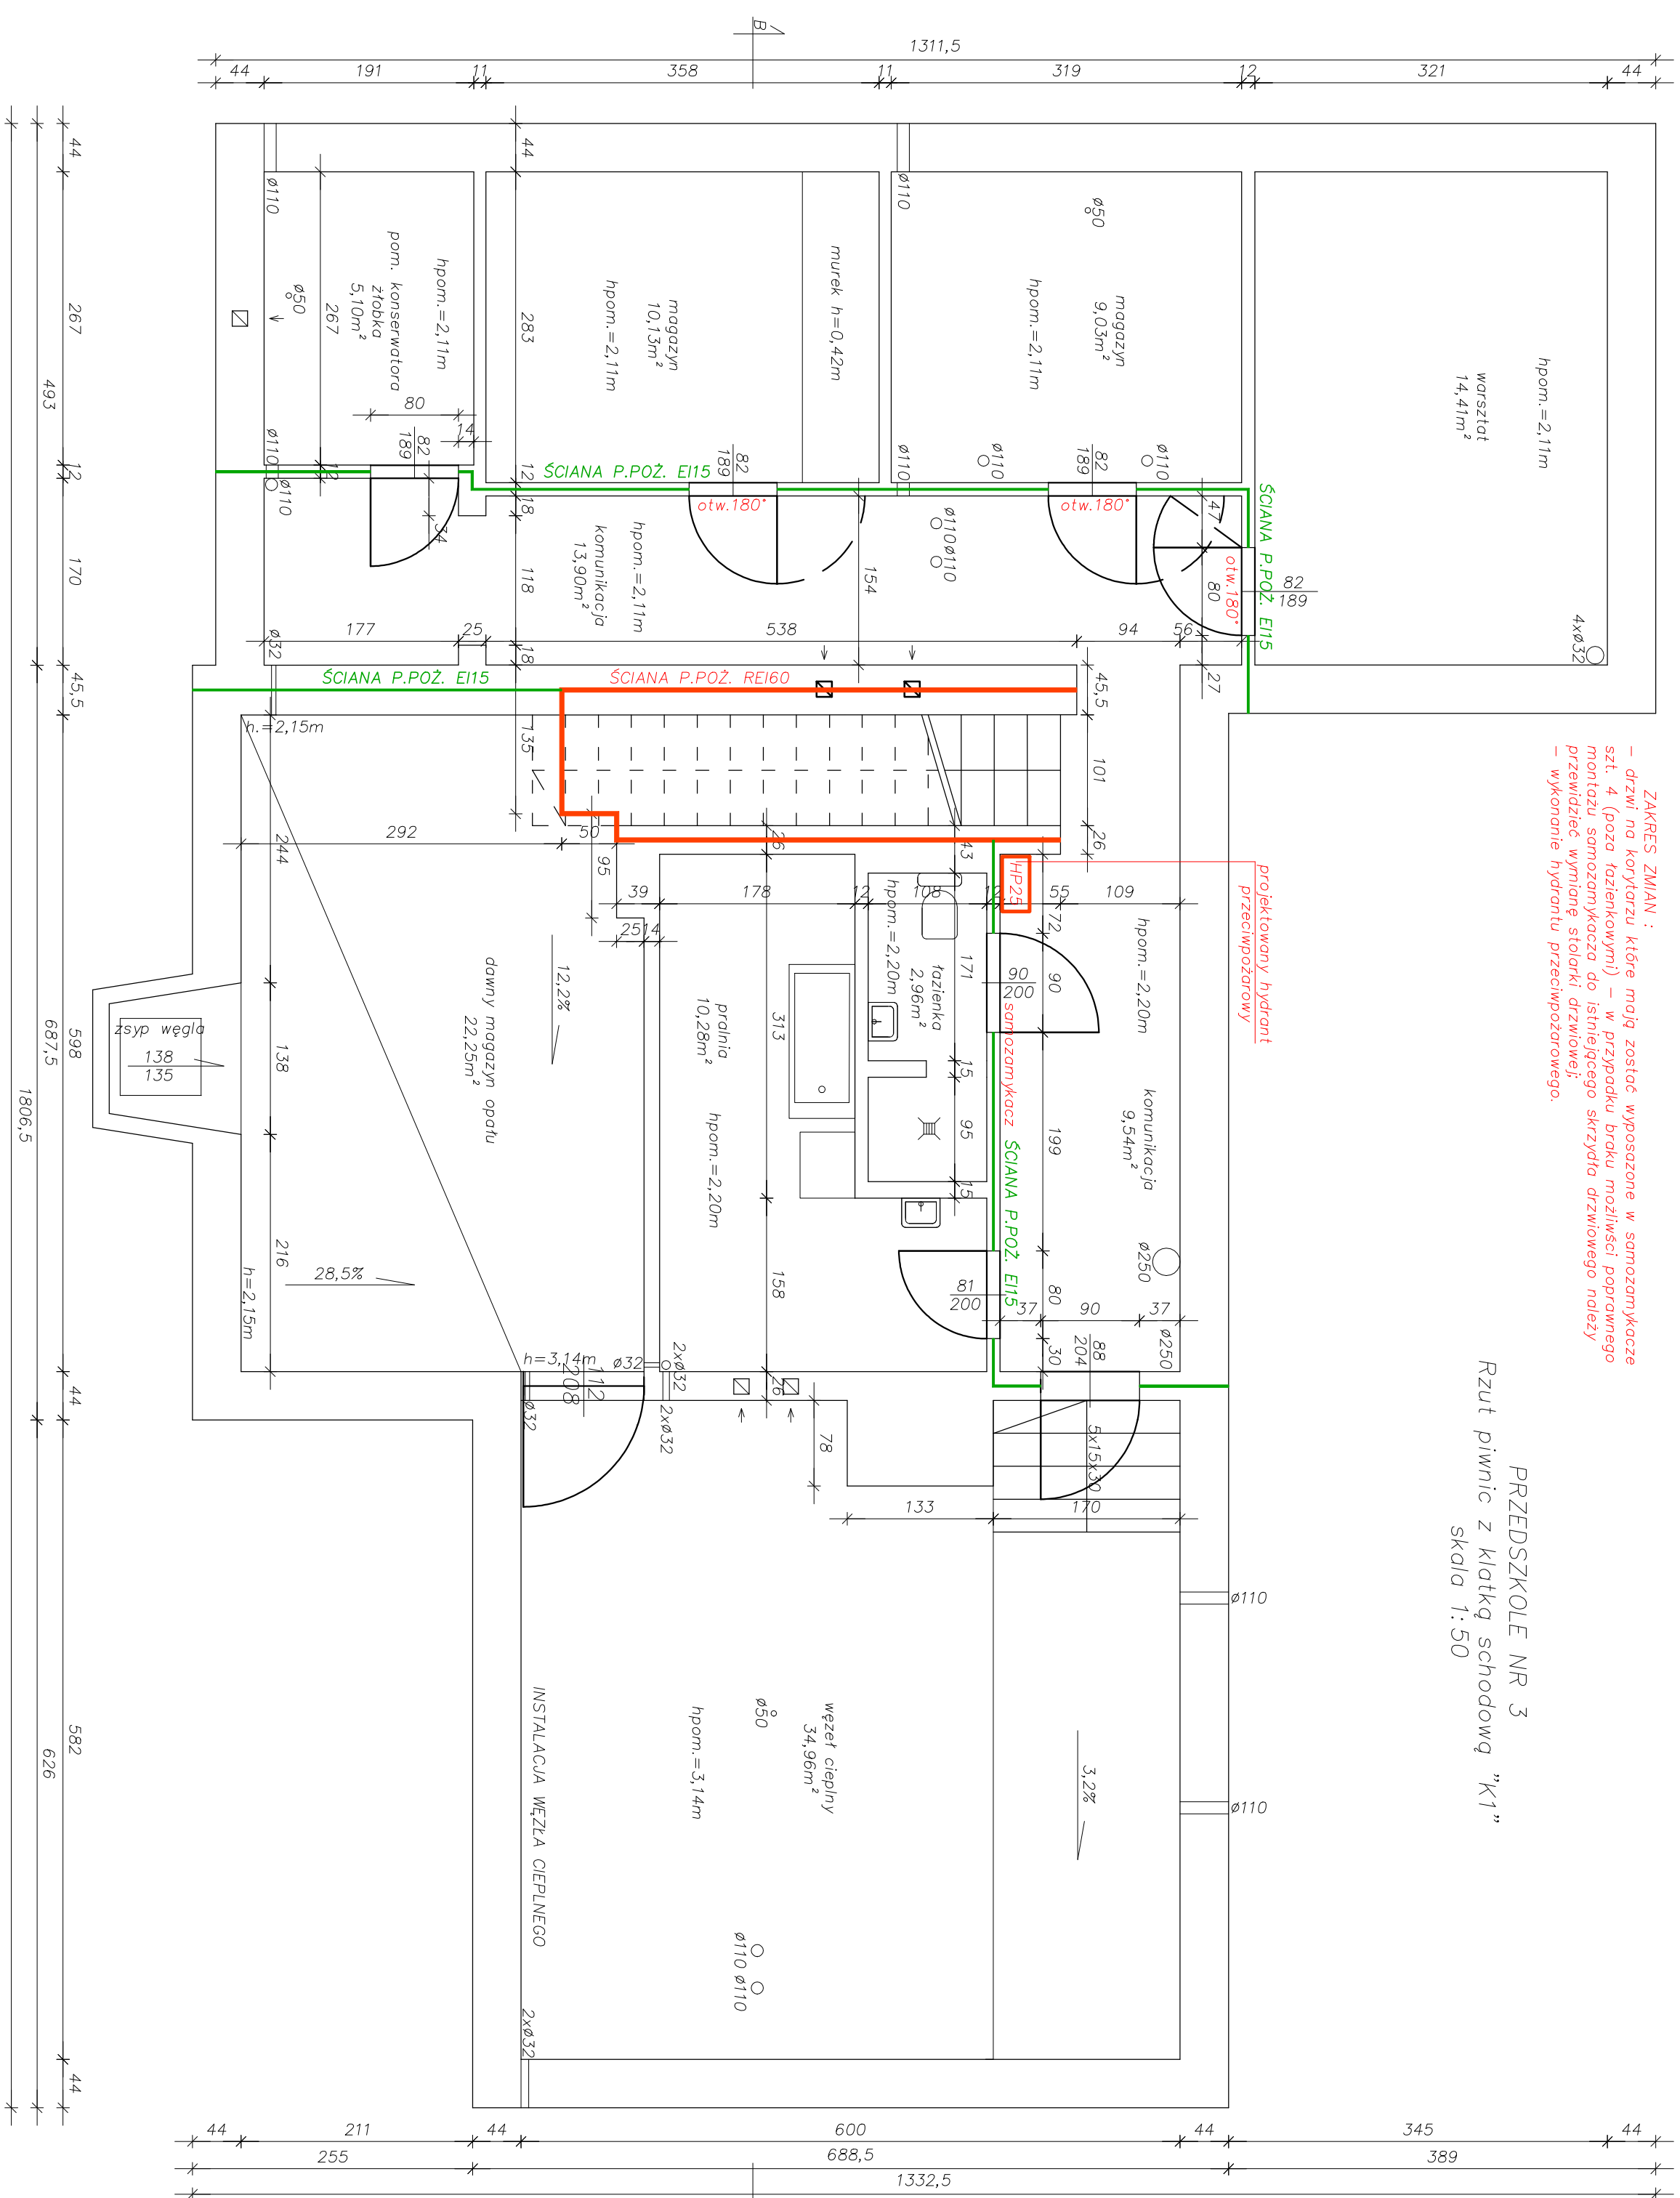

<p>WZROSTAJĄCE PRACOWNIKI</p> <p>WIEK STALBERG S.C. ul. Władysława 28, Strzelce, wroslberg@poczta.onet.pl, tel. 898-251-450</p> <p>Lukasze Gajdzisz Euro polskoscie 98-100 Łask, ul. Sejmowa 2/28, tel. 513 178 007, l.gajdzisz@poczta.onet.com</p> <p>Pracownicy budowlani Pracześlowski Publikujący nr 5 w Łasku wraz ze zmianą sposobu użytkowania czaszej budowlany na pomieszczenia towarzystwa Złotko Ogimiego.</p>			
<p>INWESTOR ul. Worszowska 14, 98-100 Łask.</p>			
<p>PROJEKTANT mgr inż. Łukasz Gajdzisz ul. bud. nr ewkl. LUD/2983/PMBK/18</p>			
<p>SPRAWOZDAWCY</p>			
<p>OPISOWANIE:</p>			
STAN:	PROJEKT	INSTRUMENT	ROZMIAR
BRANŻA:	KONSTRUKCYJNA	SKALA:	FORMAT
DATA:	01/2019 r.	1:50	A1